



LOCATION MAP  
NOT TO SCALE

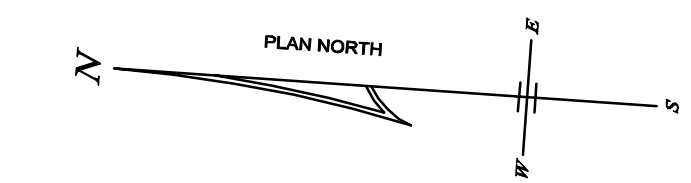

COMSTOCK AVENUE

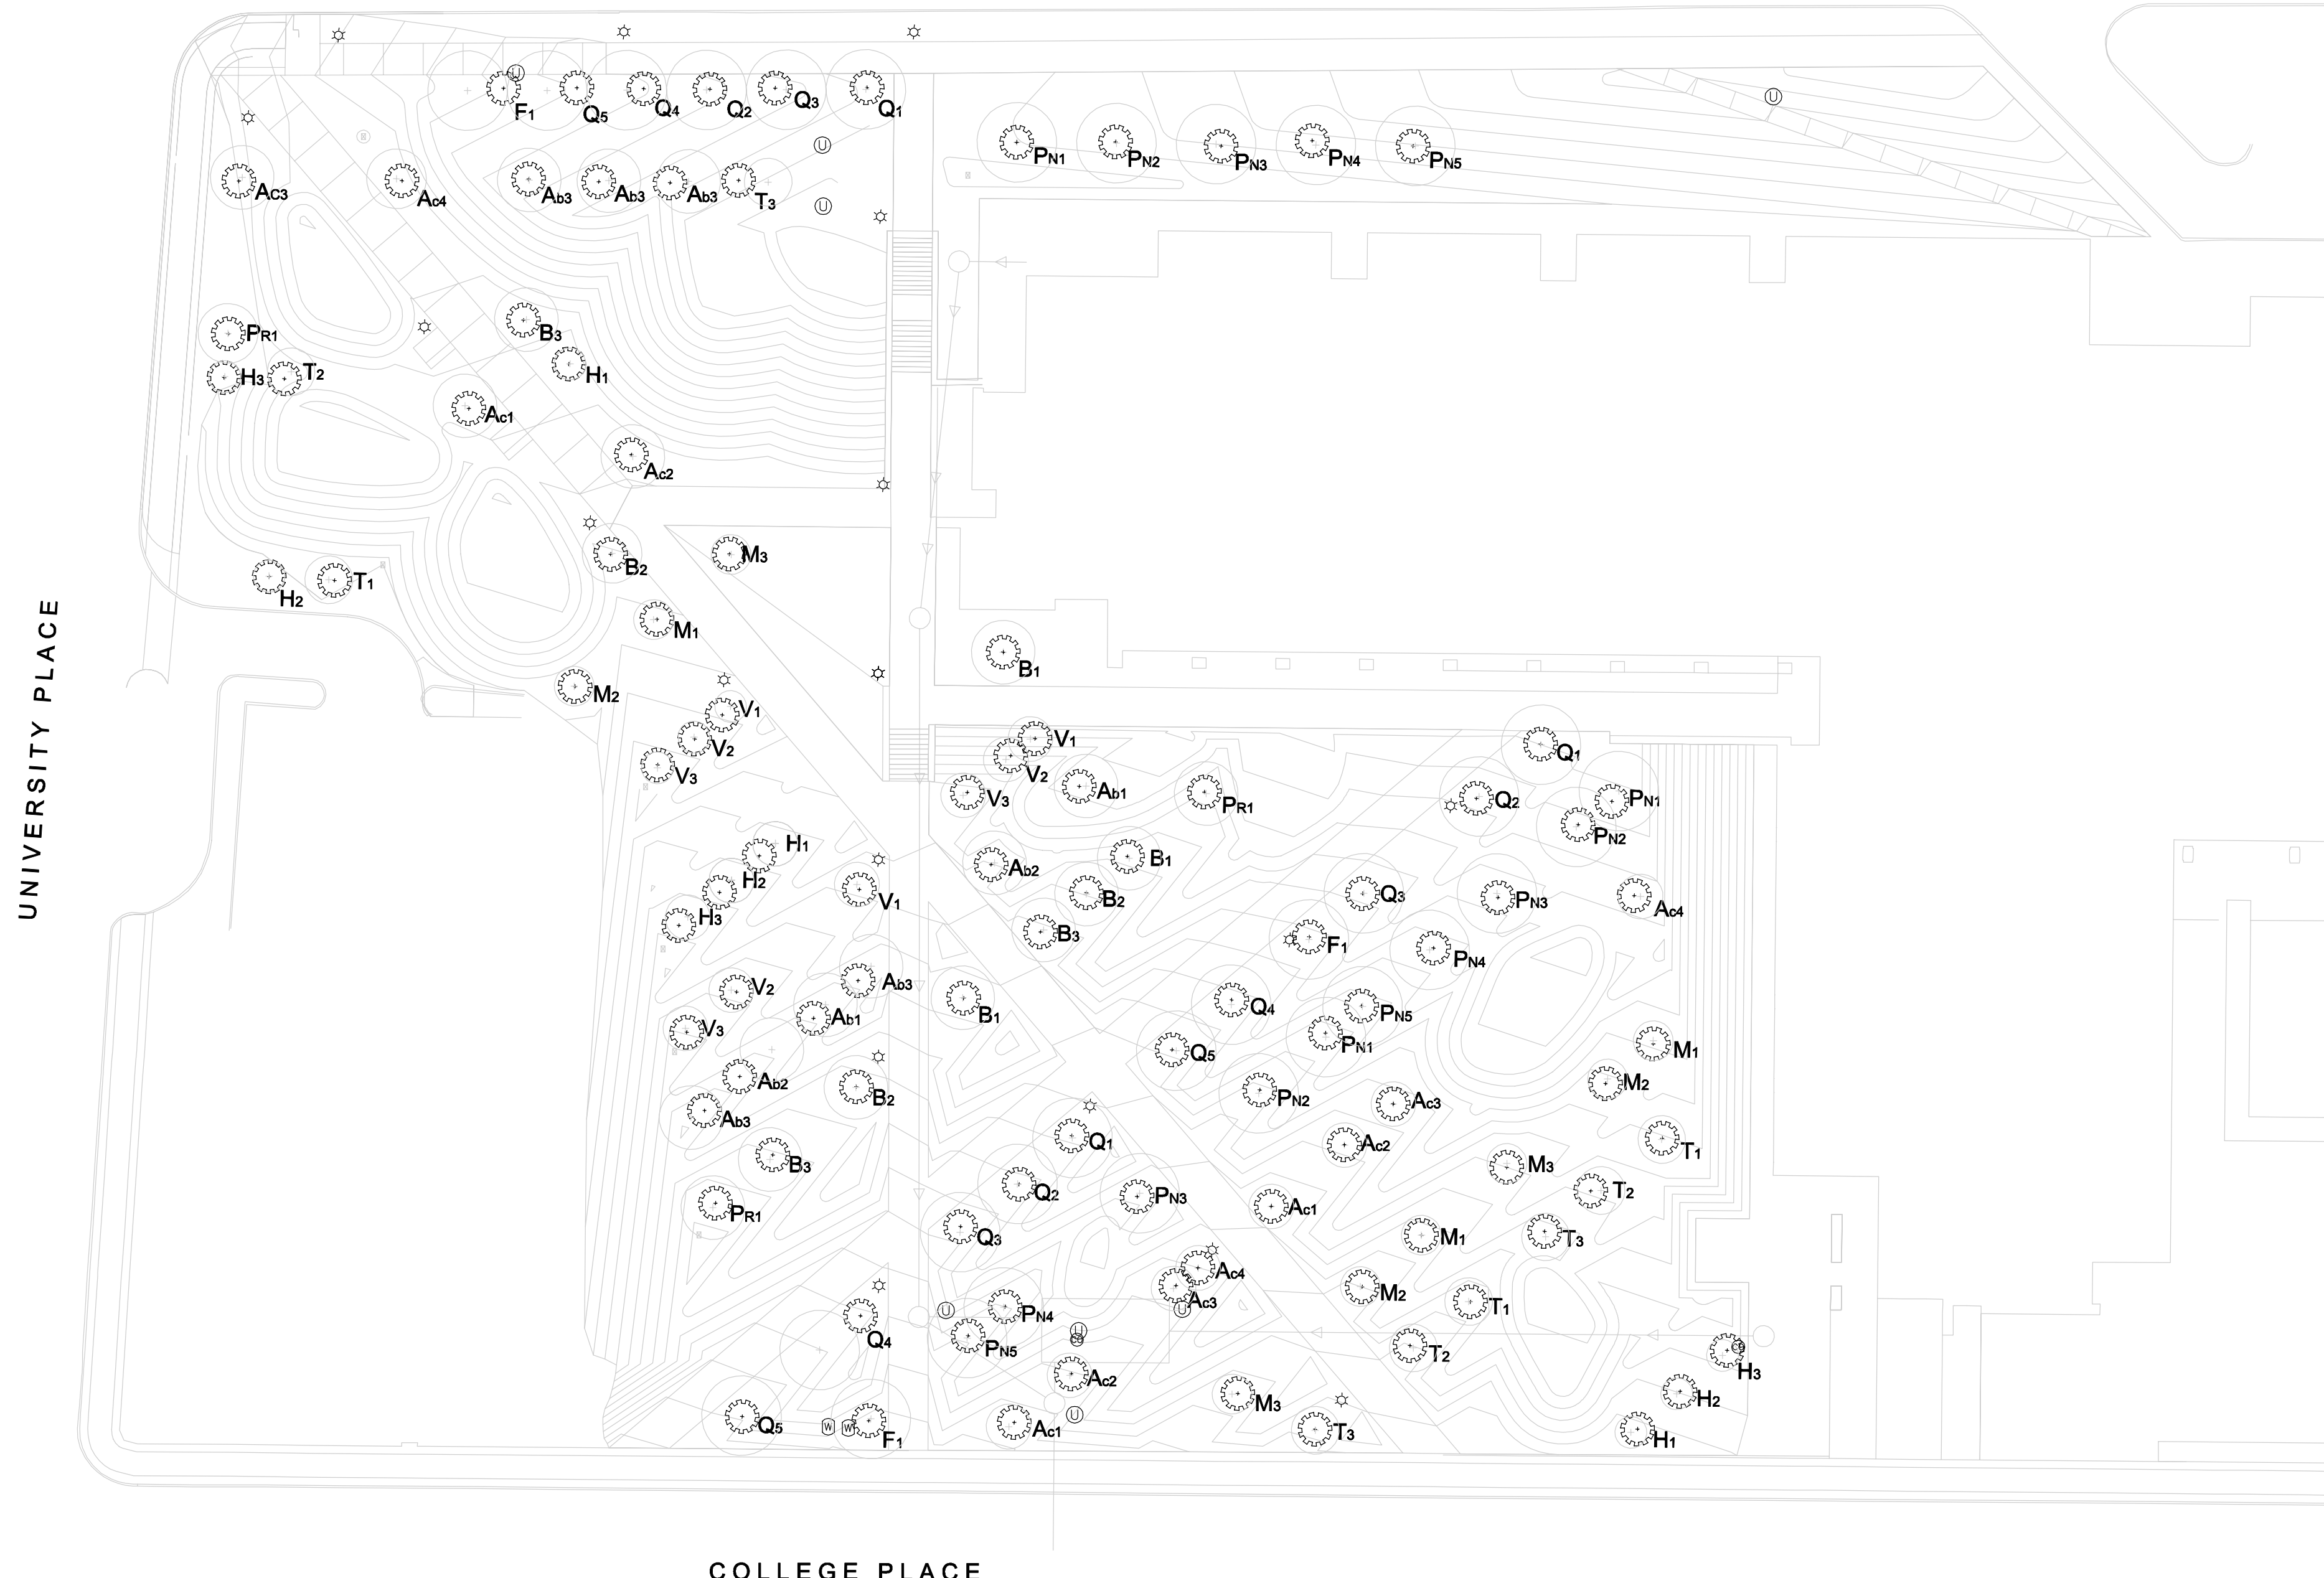


**GENERAL NOTES:**

1. Contours and site features shown are referenced from the project design drawings provided by Hargreaves Associates Landscape Architects.
2. Tree, manhole, clean out, water box and light pole locations are plotted from information provided by J.K. Tobin Construction Co., Inc.
3. This as-built sketch was assembled by Aubertine and Currier, PLLC as requested by J.K. Tobin Construction Co., Inc. Aubertine and Currier, PLLC did not perform any field location or verification for this as-built sketch.

**PROPOSED TREE SPECIES TABLE**

QUANTITY	LABEL	NAME	VARIETY	SIZE	UNIT
3	Ab1	Abies balsamea BALSAAM FIR		8'	feet
3	Ab2	Abies concolor WHITE FIR		7-8'	feet
3	Ab3	Abies koroniana KOREAN FIR		10'	feet
3	Ac1	Acer griseum PAPERBARK MAPLE		2.5'	caliper
3	Ac2	Acer saccharum SUGAR MAPLE	'Fall Fiesta'	3"	caliper
3	Ac3	Acer nigrum BLACK MAPLE		2.5'	caliper
3	Ac4	Acer grandidentatum BIGTOOTH MAPLE		4"	caliper
3	B1	Betula alleghaniensis YELLOW BIRCH		> 7'	feet
3	B2	Betula lenta SWEET OR BLACK BIRCH		7'	feet
3	B3	Betula nigra RIVER BIRCH	'Cully Heritage'	12'	feet
3	F1	Fagus grandifolia AMERICAN BEECH		3"	caliper
3	H1	Hamamelis mollis CHINESE WITCHHAZEL	'not 'x intermedia'	#7	gallon
3	H2	Hamamelis virginiana VERNAL WITCHHAZEL		5'	feet
3	H3	Hamamelis virginiana COMMON WITCHHAZEL		5'	feet
3	M1	Magnolia acuminata BUTTERFLIES MAGNOLIA	'Butterflies'	6-8'	feet
3	M2	Magnolia virginiana SWEETBAY MAGNOLIA		8-10'	feet
3	M3	Magnolia stellata STAR MAGNOLIA		6-8'	feet
3	Pn1	Pinus contorta LOROPKLE PINE		> 10'	feet
3	Pn2	Pinus koraiensis KOREAN PINE		12'	feet
3	Pn3	Pinus ponderosa PONDEROSA PINE		> 10'	feet
3	Pn4	Pinus strobus EASTERN WHITE PINE		10-12'	feet
3	Pn5	Pinus virginiana VIRGINIA PINE		> 8'	feet
3	Pr1	Prunus pensylvanica PIN CHERRY		2"	caliper
3	Q1	Quercus alba WHITE OAK		3"	caliper
3	Q2	Quercus acutissima SAWTOOTH OAK		2.5-3"	caliper
3	Q3	Quercus imbricaria SHINGLE OAK		3"	caliper
3	Q4	Quercus rubra RED OAK		3"	caliper
3	Q5	Quercus shumardi SHUMARD OAK		3"	caliper
3	T1	Tsuga canadensis EASTERN HEMLOCK		8'	feet
3	T2	Tsuga caroliniana CAROLINA HEMLOCK		8'	feet
3	T3	Tsuga diversifolia NORTHERN JAPANESE HEMLOCK		8'	feet
3	V1	Viburnum lentago SWEET VIBURNUM		6'	feet
3	V2	Viburnum dilatatum LINDEN VIBURNUM	'troquois'	4-5'	feet
3	V3	Viburnum prunifolium BLACKHAW VIBURNUM		#10	gallon

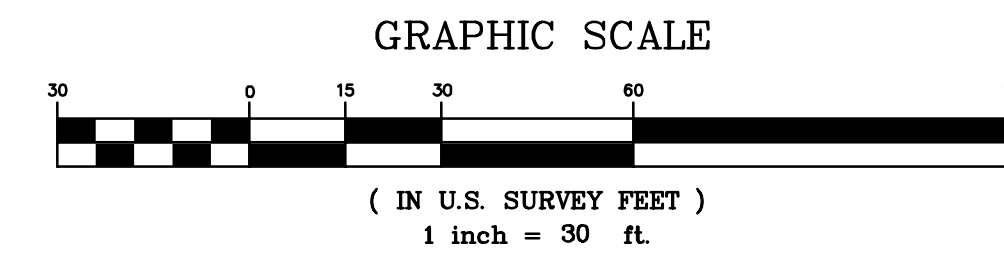

- LEGEND**
- ⊕ MANHOLE
  - ⊗ CLEAN OUT
  - ⊙ WATER BOX
  - ⊛ LIGHT POLE
  - ⊙ TREE

The above Architect, Engineer or Land Surveyor states that to the best of his or her knowledge, information and belief, the plans and specifications are in accordance with applicable requirements of New York State. It is a violation of New York State Law for any person, unless acting under the direct supervision of a Registered Architect, Licensed Professional Engineer or Licensed Land Surveyor to alter this document in any way. If altered, such licensee shall affix his or her seal and the notification "altered by" followed by his or signature, date and a specific description of the alteration.  
© COPYRIGHT 2014  
AUBERTINE and CURRIER ARCHITECTS, ENGINEERS & LAND SURVEYORS, PLLC

**SKETCH OF TREE LOCATIONS  
LIFE SCIENCES LANDSCAPE 2013  
SYRACUSE UNIVERSITY COLLEGE OF ARTS & SCIENCES  
CITY OF SYRACUSE  
ONONDAGA COUNTY, NEW YORK**

PROJECT NO: 2013-053  
SCALE: 1" = 30'  
DRAWN BY: J.D.B.  
CHECKED BY: J.J.J.  
ISSUE DATES:  
April 15, 2014  
April 22, 2014

2013-153 SULS-V-SK001

**SK-101**